


Appendix U

Final Survey

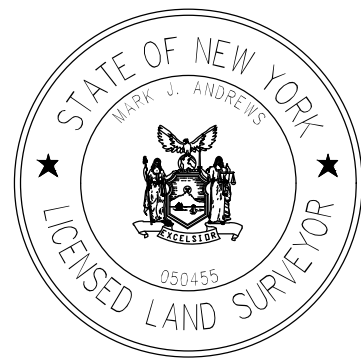

Mark J. Andrews


NOTE: SILO OUTLINE IS REPRODUCED FROM FIGURE 4-4 OF THE SILO CLOSURE PLAN.

DATE	REVISION/TYPE
7/16/19	FINAL SURFACE GRADES COLLECTED
6/3/19	SILOS 2 & 3 EXCAVATION DEPTH
5/14/19	SILO 5 EXCAVATION DEPTH
11/27/18	SILO 6 EXCAVATION DEPTH
11/7/18	SILO 1 EXCAVATION DEPTH
10/23/18	SILO 4 EXCAVATION DEPTH

LEGEND:

x 651.10 INDICATES FINAL GRADE ELEVATION

---895--- EXISTING CONTOURS

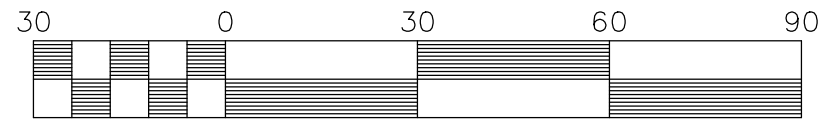

AS-BUILT SILO EXCAVATION
FORMER NIKE BASE SITE BU-34/35
PART OF LOT 56, TOWNSHIP 9, RANGE 6
HOLLAND LAND SURVEY
TOWN OF AURORA, ERIE COUNTY, NEW YORK



**GPI ENGINEERING, LANDSCAPE
ARCHITECTURE & SURVEYING, LLP**
ENGINEERING • SURVEYING • LANDSCAPE ARCHITECTURE
4950 GENESEE STREET, SUITE 100
BUFFALO, NEW YORK 14225
(716) 633-4844 FAX 633-4940

Job No. 6733-GRADING PLAN Date: OCTOBER 23, 2018
Scale 1" = 30' Tax No. 163.00-2-36.1&36.2